City of Santa Fe, New Mexico

memo

DATE: August 19, 2015

TO: Mayor Gonzales & City Councilors

VIA: Brian K. Snyder, City Manager

FROM: Yolanda Y. Vigil, City Clerk

ITEM & ISSUE

Change of Floor Plans for Dispenser License Nos. 2507 ("License 2507") and 2746 ("License 2746") located at the Drury Plaza Hotel-Santa Fe, 228 East Palace.

BACKGROUND AND SUMMARY

There are currently two Dispenser Licenses located at Drury Plaza Hotel-Santa Fe; License Nos. 2507 and 2746. These Dispenser Licenses were approved by the Governing Body on February 26, 2014 and March 12, 2014.

The two licensees propose to switch the hotel guest rooms from the approved floor plans of one licensee to the approved floor plans of the other licensee. License #2507 is owned and operated by Drury Hotels Company, LLC ("DHC"). This license is currently approved for use in the hotel lobby area and the area immediately above the hotel lobby area where hotel guests gather each evening. DHC refers to these evening gatherings as kickbacks and the kickbacks are sponsored by DHC.

License 2746 is owned by Santa Fe Café, LLC and leased to Sedler's Santa Fe, LLC. This license is used in the restaurant, bar, meeting rooms, garden area, and conference center.

The initial floor plans for License 2746 included the guest rooms because any future room service would be provided by the restaurant. There has been no room service to date and no room service is currently planned. The owners of both licenses would like to transfer the guest rooms from License 2746 to License 2507 so that hotel guests that want to carry a drink from a kickback gathering to their guest room may do so.

The two proposed modifications are in the change of the guest rooms service from License 2746 to 2507 and adding the patio area immediately outside of the restaurant to License 2507.

ACTION REQUESTED

I request that the City Council indicate its decision on the change of floor plans for License Nos. 2507 and 2746 which are located at the Drury Plaza Hotel-Santa Fe, 228 East Palace.

Attachments: Letter/Linda A. Aikin, Esq.
Change of Floor Plans/Expansion of Liquor Licensed Premise Applications

LINDA L. AIKIN
LAWYER
530B HARKLE ROAD
SANTA FE, NEW MEXICO 87505
(505) 982-6224
FAX: (505) 992-8378
E-Mail lla@cybermesa.com

July 13, 2015

Hand Delivered

Mary Kay Root, Esq.
Director
Alcohol and Gaming Division
2550 Cerrillos Road
Santa Fe, New Mexico

Re: Floor Plan Changes for License Nos. 2507 and 2746; Drury Plaza Hotel in Santa Fe

Dear Ms. Root:

Enclosed are two floor plan applications. Both applications are for liquor licenses operated at Drury Plaza Hotel in Santa Fe. The two licensees propose to flip the hotel guest rooms from the approved floor plans of one licensee to the approved floor plans of the other licensee.

Liquor License No. 2507 ("License 2507") is owned and operated by Drury Hotels Company, LLC. ("DHC") License 2507 is currently approved for use in the hotel lobby area and the area immediately above the hotel lobby area where hotel guest gather each evening. DHC refers to these evening gatherings as kickbacks and the kickbacks are sponsored by DHC.

Liquor License No. 2746 ("License 2746") is owned by Santa Fe Cafe, LLC and leased to Sedlar's Santa Fe, LLC. License 2746 is used in the restaurant, bar, meeting rooms, garden area and conference center.

The initial floor plans for License 2746 included the guest rooms because any future room service would be provided by the restaurant. There has been no room service to date and no room service is currently planned. The owners of both licenses would like to transfer the guest rooms from License 2746 to License 2507 so that hotel guests that want to carry a drink from a kickback gathering to their guest rooms may do so.

The change in guest rooms is the only proposed change, except that the patio area immediately outside of the restaurant was not initially approved because no photos of the patio enclosure could be provided at that time. The photos of that patio are included with the enclosed floor plan application for License 2746.

These changes do not result in any areas being closer to a church or school. The City of Santa Fe granted waivers for the liquor licenses operated at Drury Plaza Hotel. These requested changes do not change the areas where liquor is served or sold and will not be visible to anyone.

Please call if you have any questions.

Very truly yours,

Linda L. Aikin
Enclosures

7/13/15
75
1735345 RECEIVED

New Mexico Regulation and Licensing Department

JUL 13 2015

ALCOHOL AND GAMING DIVISION

Toney Anaya Building • 2550 Cerril los Road • Santa Fe, New Mexico 87505
(505) 476-4875 • Fax (505) 476-4595 • www.rld.state.nm.us/AGD

ALCOHOL & GAMING DIVISION

____Fee $75.00 **Fees are Non-Refundable**

CHANGE OF FLOOR PLAN /EXPANSION OF LIQUOR LICENSED PREMISE APPLICATION
15 NMAC 10.3.2 13.1

A Licensee may not change or expand the licensed premises without prior written approval of the Director. Applications to change or expand the licensed premises shall be submitted along with the required documentation and application fee. If the change or expansion of the licensed premises is twenty-five **(25%)** or more of the total existing square footage of the licensed premises, the Director may require the licensee to file an application for a transfer of location. **Proof of tenancy and photographs with a detailed floor are required for the expansion area. Please attach a copy of your existing approved floor plan along with an 8 ½ x 11detailed floor plan that includes the existing approved premises and any proposed change or expansion. Please label all areas and include all entrances, exits, walls or enclosures as well as dimensions for any expansion. The licensee cannot make any changes or expand the premises until approval has been granted for this request. A before and after site inspection may be scheduled.**

Liquor License Number 2507 Telephone Number 505-424-2175 Fax Number _____

Business Name (DBA) Drury Plaza Hotel-Santa Fe Owner Name Drury Hotels Company, LLC

Mailing Address 101 S. Farrar Drive City Cape Girardeau State Missouri Zip 63701

License Location 228 E. Palace Ave City Santa Fe State New Mexico Zip 87501

Current square footage 9,360 Additional square footage you would like to add/change 114,719

Total square footage (add both amounts above) 124,079 Reason for request Adding guest rooms.

Will the proposed expansion bring the licensed premises within 300 feet of a church or school? No

Has there been any change in the ownership or operation of the licensee? No

If so, explain _____

I Linda L. Aikin (print name) Licensee for Liquor License No. 2507 hereby attest that the requested change meets the definition of "licensed premises" in NMSA 1978 60-3A-3 (M), which states in part " 'licensed premises' means the contiguous areas or areas connected by indoor passageways of a structure and the outside dining, recreation and lounge areas of the structure that are under the direct control of the licensee..."

You must sign and date this form in the presence of a notary public

Submitted by (print name) Linda L. Aikin

Signature [signature] Title Resident Agent Date 7-7-15

NOTARY PUBLIC USE ONLY

SUBSCRIBED AND SWORN TO before me this 7th Day of July 2015 By Linda L. Aikin

Notary Public [signature] My Commission Expires: _____

OFFICIAL SEAL
Amelia J. Martinez
NOTARY PUBLIC
STATE OF NEW MEXICO
My Commission Expires: 7-1-18

LOCAL GOVERNING BODY APPROVAL – (Required on expansion requests only)

Print Name _____ Title _____ Date _____

Signature _____ Phone _____ Fax _____

Alcohol and Gaming Use Only: ✓ **Approved** _____ **Disapproved**

By Brenda Mares **Date** 7-13-15

Drury Hotels Company LLC
License No. 2507

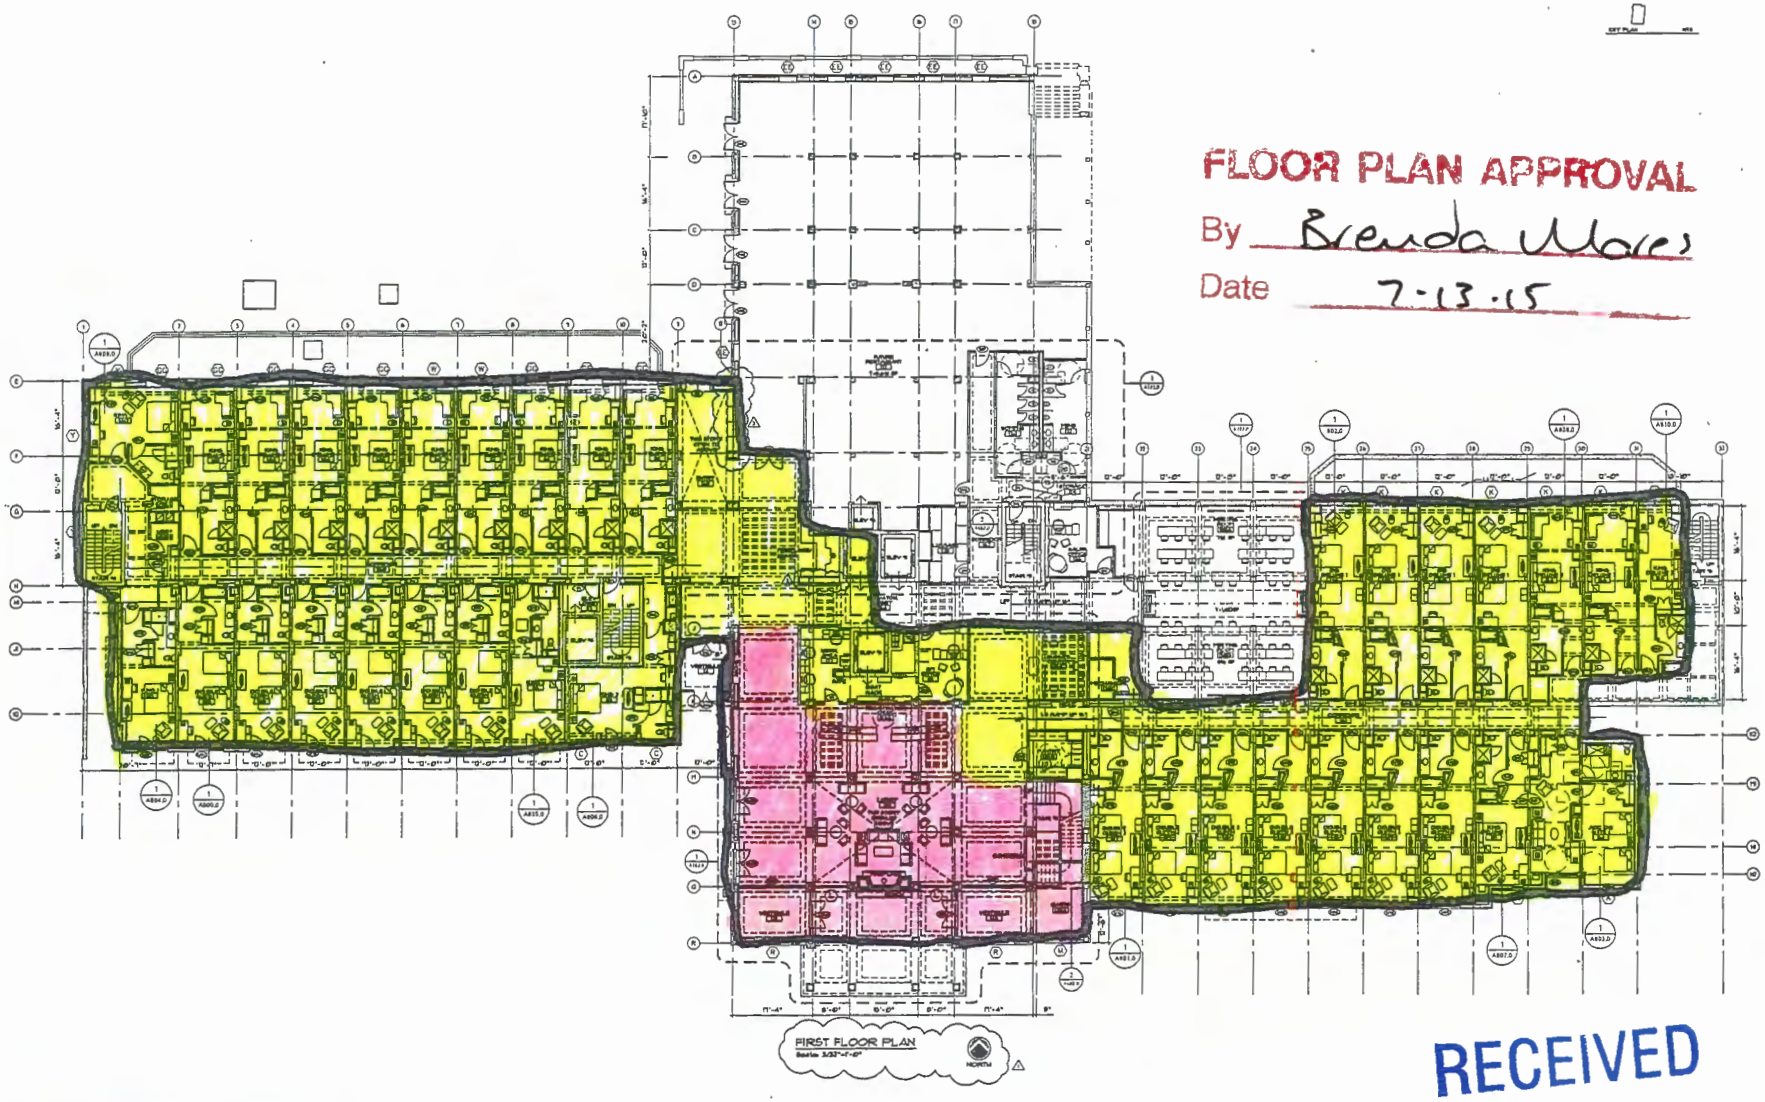

FLOOR PLAN APPROVAL
By Brenda Mares
Date 7-13-15

RECEIVED
JUL 13 2015
ALCOHOL & GAMING DIVISION

Current Area
Adding Area

DRURY SOUTHWEST INC.

HoganGroup

DRURY PLAZA HOTEL
Restoration - Renovation - Additions
228 PALACE AVENUE
Santa Fe, New Mexico 87501

FIRST FLOOR PLAN

H.A101.0

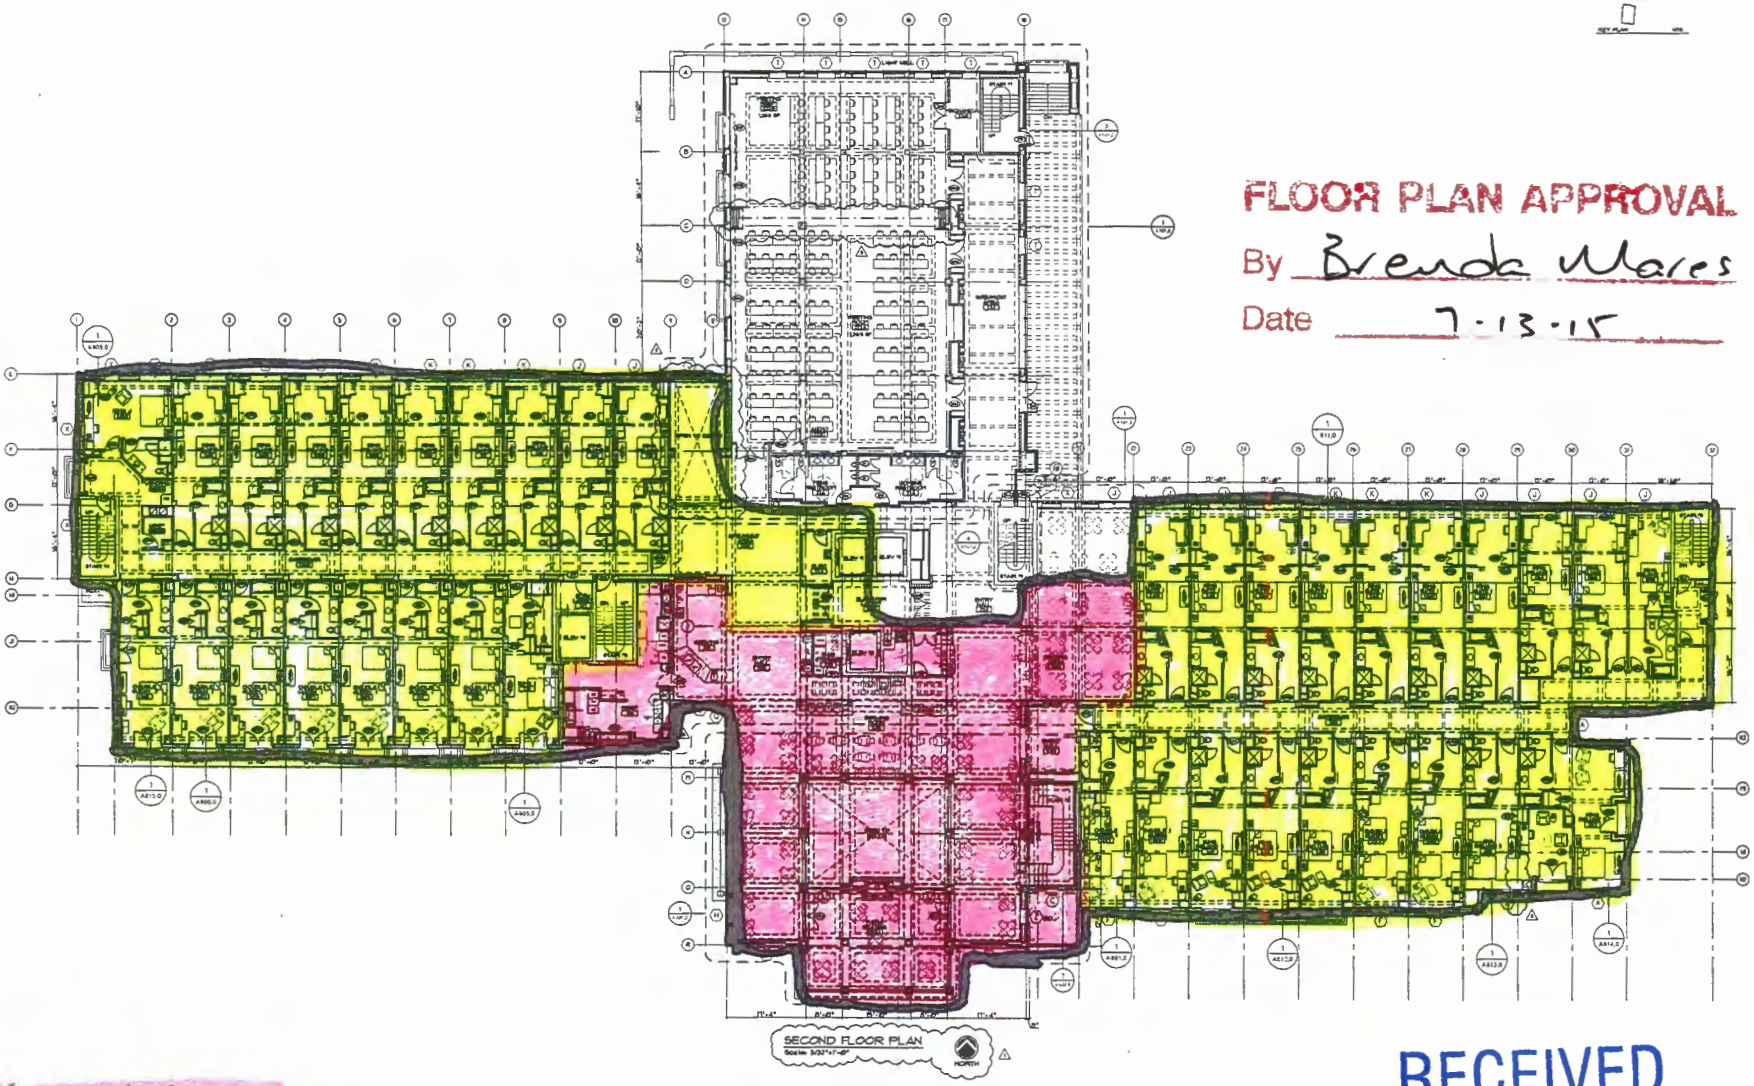

FLOOR PLAN APPROVAL

By Brenda Mares

Date 7-13-15

RECEIVED

JUL 13 2015

ALCOHOL & GAMING DIVISION

Current Area

Adding Area

DATE ISSUED: 07/13/2012 PERMIT CONSTRUCTION SET DATE: 8/24/2012

REVISIONS

△ 9/26/2012

△ 12/14/2012

△ 1/31/2013

BUILDING PERMIT / CONSTRUCTION DRAWINGS

DRURY SOUTHWEST INC.

HoganGroup

HOGAN GROUP INC. 505-984-1313 FAX 505-984-5064
ARCHITECTS • PLANNERS • INTERIORS • LANDSCAPES
912 OLD PECOS TRAIL SANTA FE, NEW MEXICO 87505

DRURY PLAZA HOTEL

Restoration - Renovation - Additions

228 PALACE AVENUE

Santa Fe, New Mexico 87501

SECOND FLOOR PLAN

H.A102.0

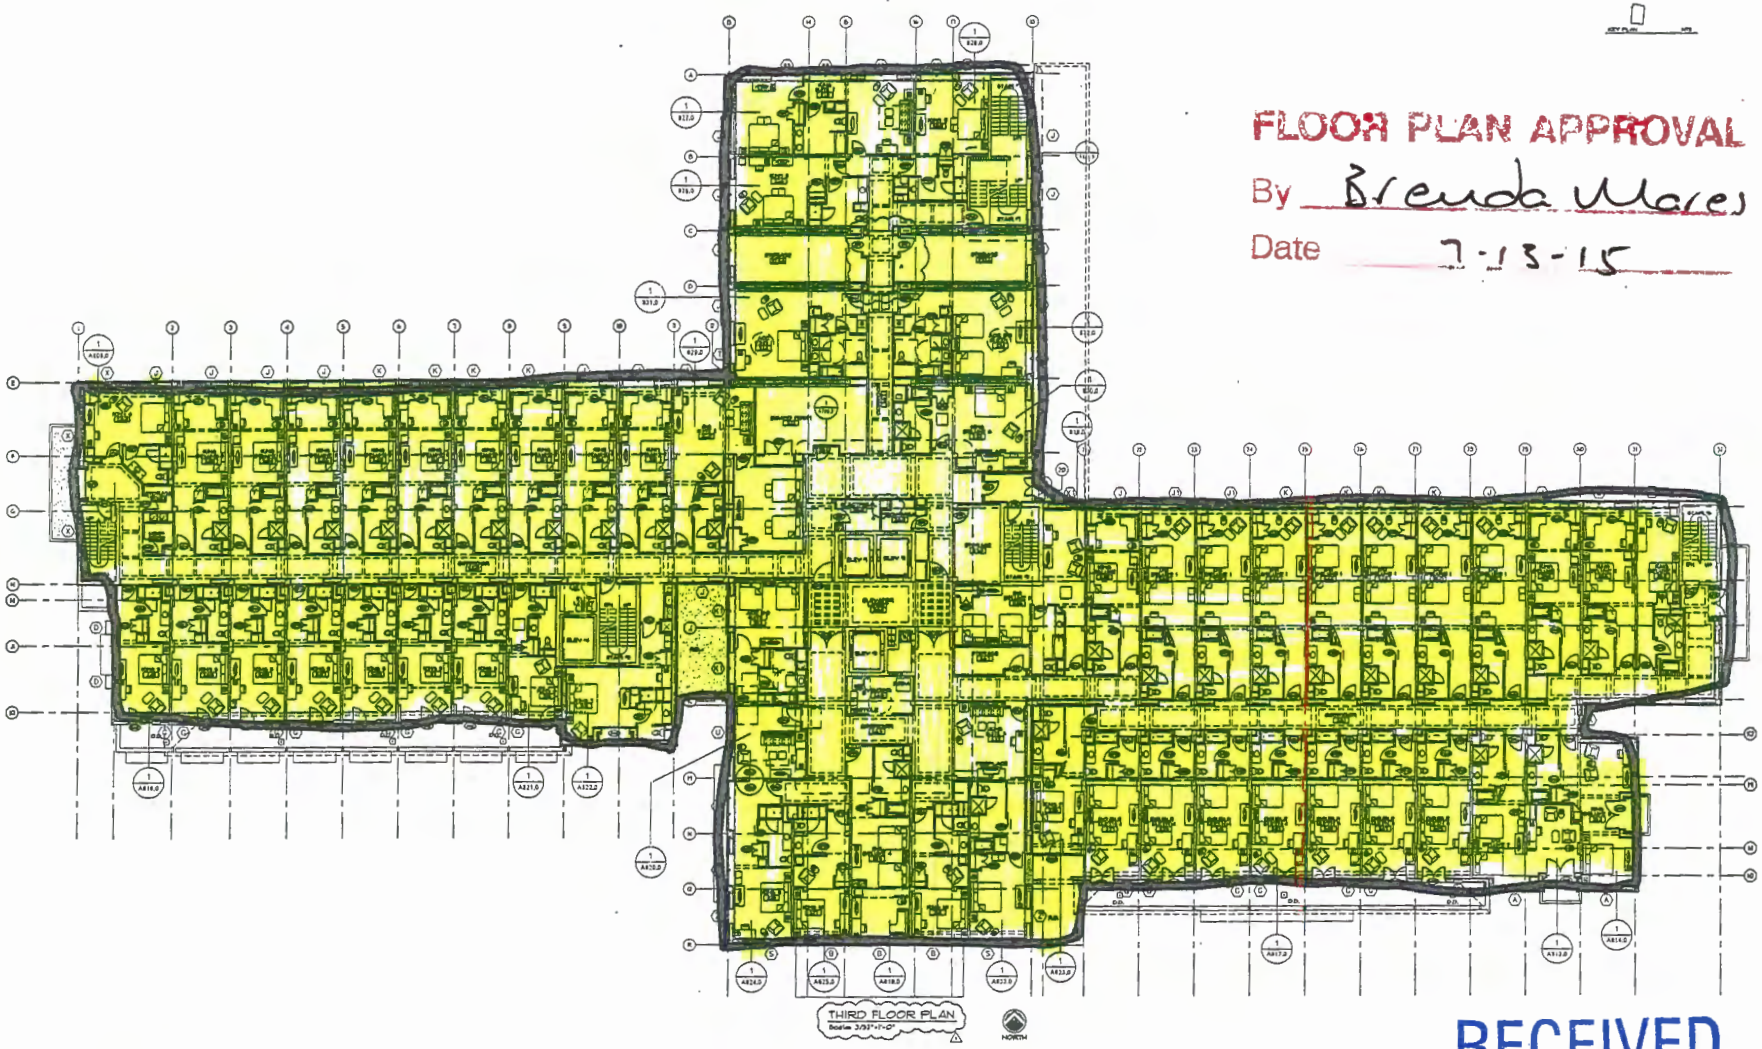

FLOOR PLAN APPROVAL

By Brenda Mares

Date 7-13-15

RECEIVED

JUL 13 2015

ALCOHOL & GAMING DIVISION

Adding Area

DRURY SOUTHWEST INC.

HoganGroup

DRURY PLAZA HOTEL

Restoration - Renovation - Additions

228 PALACE AVENUE

Santa Fe, New Mexico 87501

THIRD FLOOR PLAN

H.A103.0

BUILDING PERMIT / CONSTRUCTION DRAWINGS

8

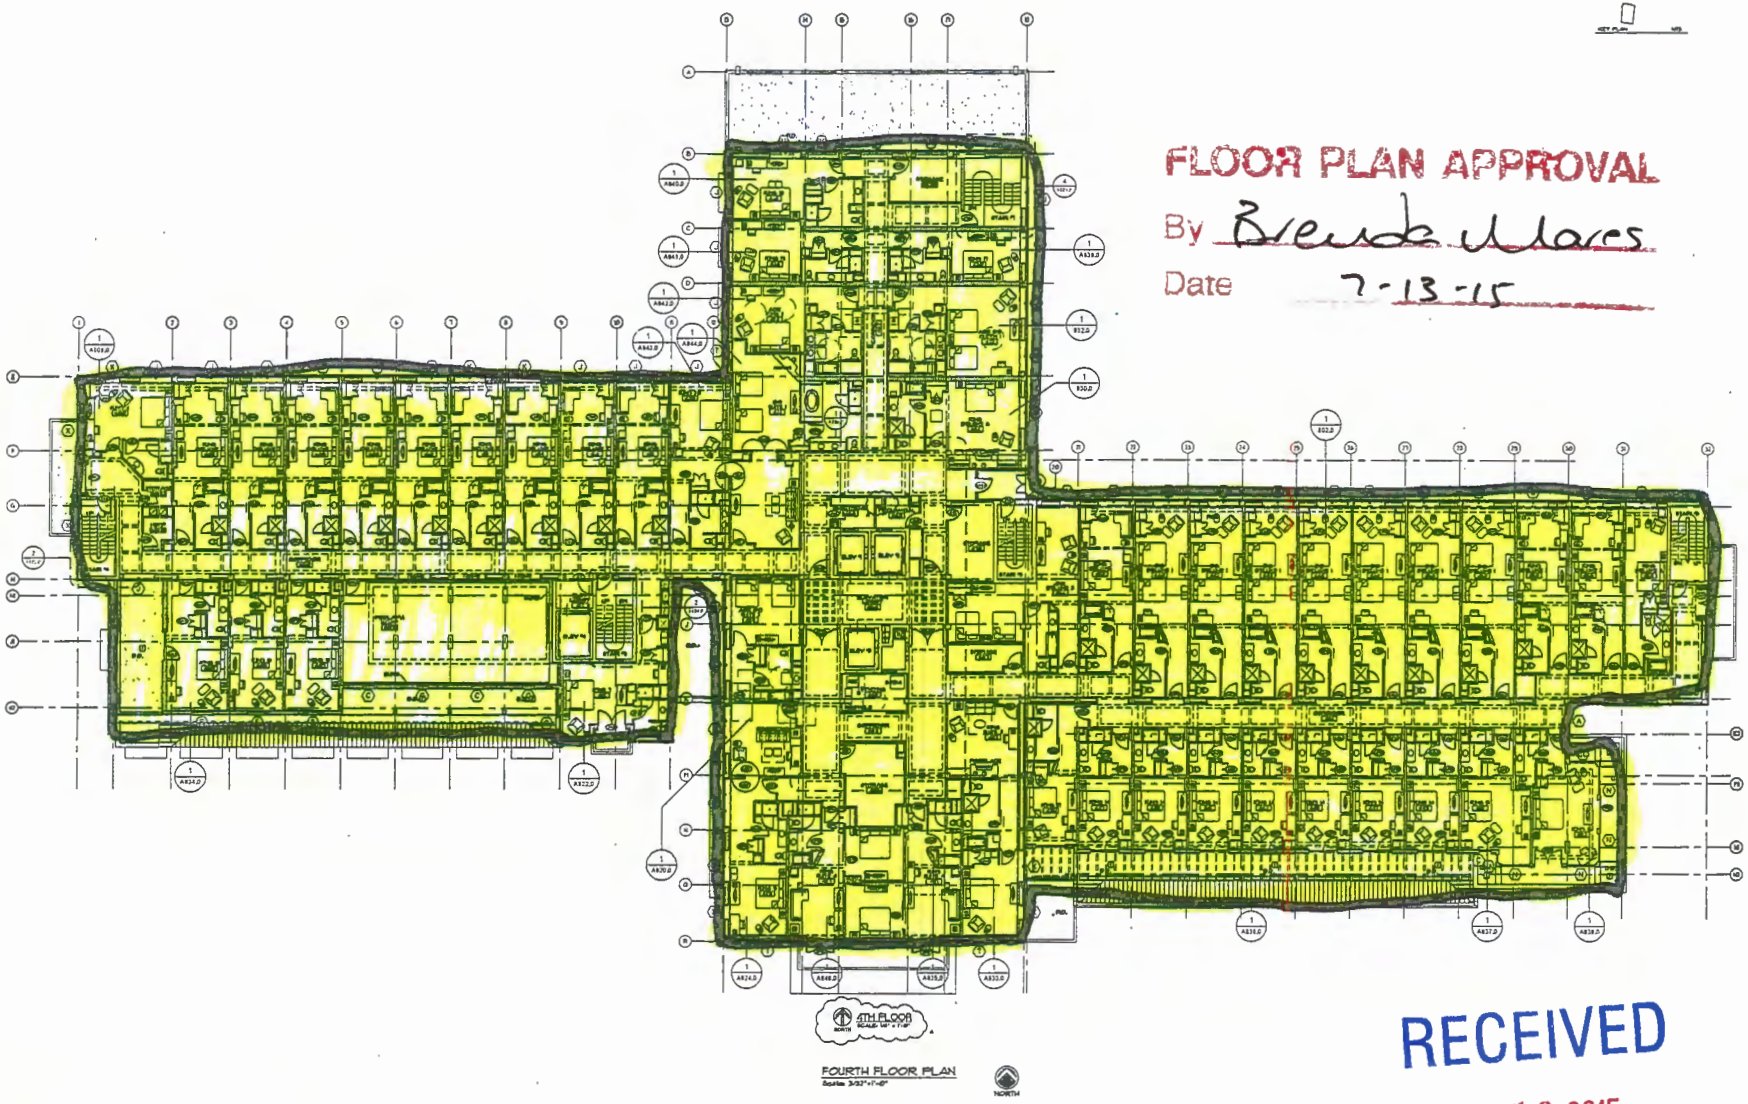

FLOOR PLAN APPROVAL

By Brenda Ulacs

Date 7-13-15

RECEIVED

JUL 13 2015

ALCOHOL & GAMING DIVISION

Adding Area

DATE ISSUED: 07/13/2012 PERMIT CONSTRUCTION SET DATE: 4/24/2012

REVISIONS:

9/24/2012

12/14/2012

TUB AND SHOWER CHANGES SEE RU BLOWUPS FOR DETAILS 1/21/13

BUILDING PERMIT / CONSTRUCTION DRAWINGS

DRURY SOUTHWEST INC.

HoganGroup

DRURY PLAZA HOTEL

Restoration - Renovation - Additions

228 PALACE AVENUE

Santa Fe, New Mexico 87501

FOURTH FLOOR PLAN

H.A104.0

FLOOR PLAN APPROVAL
By Brenda Ularo
Date 7-13-15

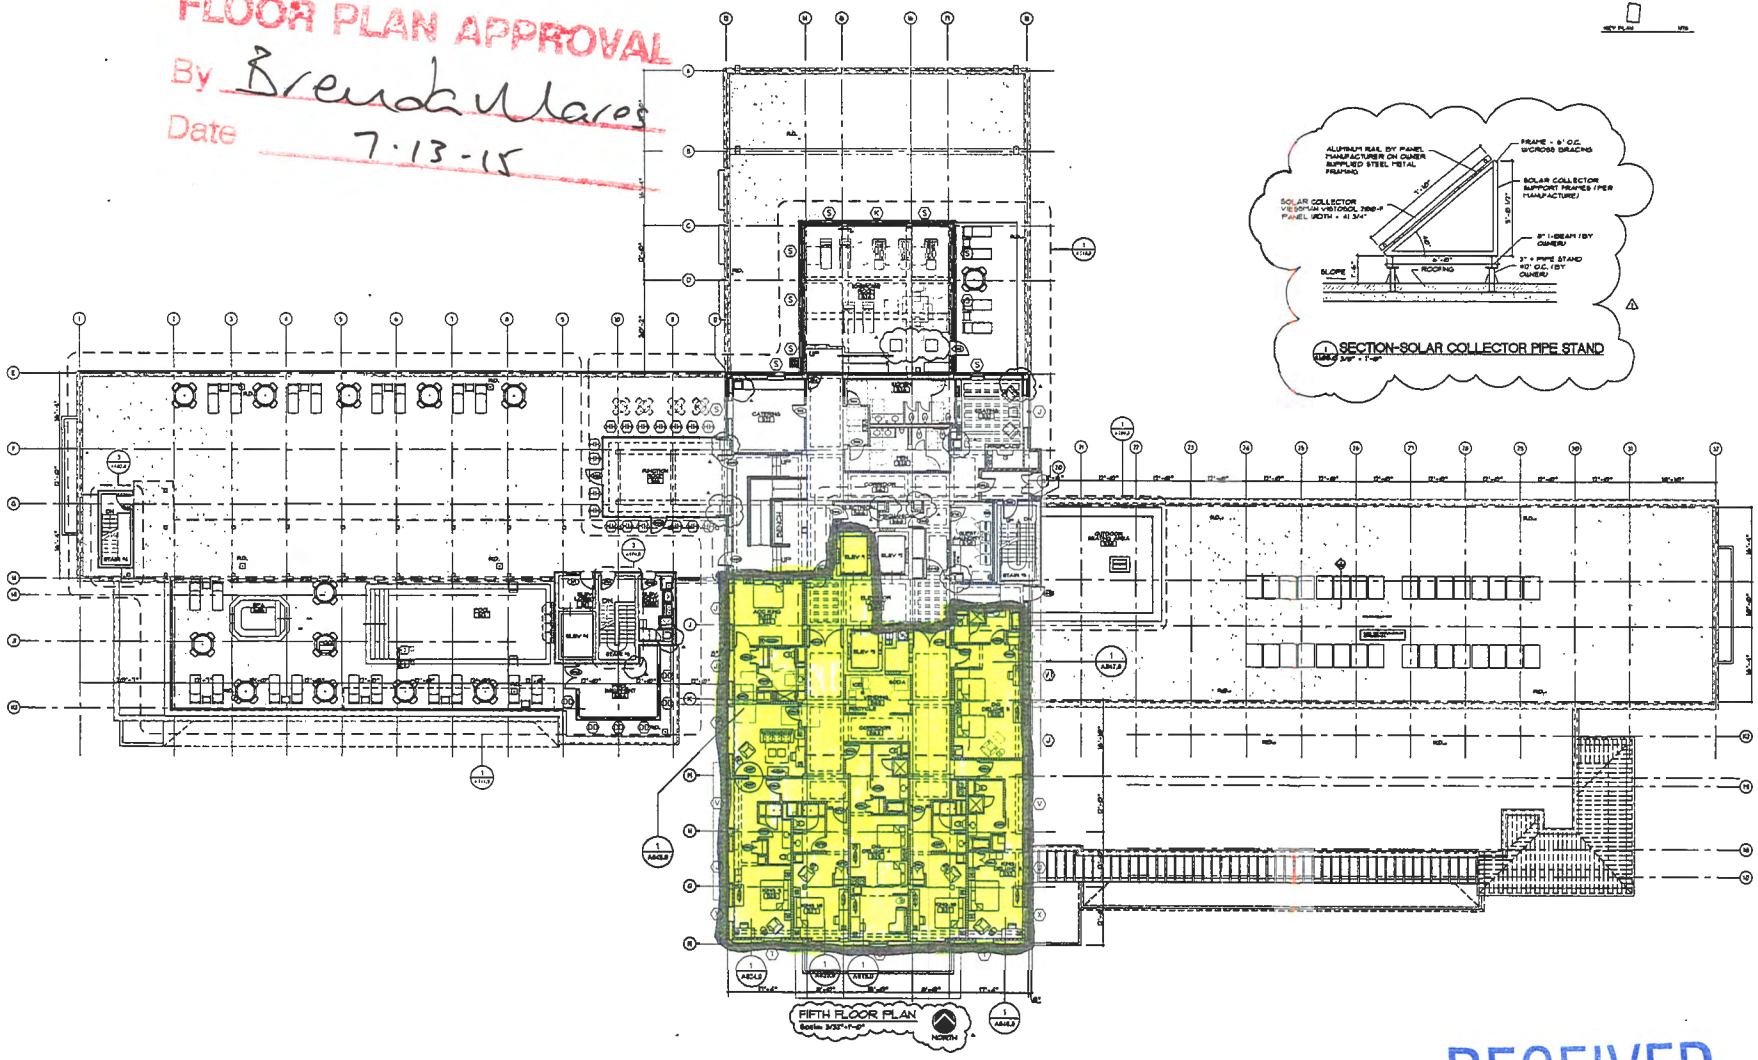

RECEIVED
JUL 13 2015
ALCOHOL & GAMING DIVISION

Adding Area

DRURY SOUTHWEST INC.
DRURY PLAZA HOTEL
Restoration - Renovation - Additions
228 PALACE AVENUE
Santa Fe, New Mexico 87501

FIFTH FLOOR PLAN

H.A105.0

10

New Mexico Regulation and Licensing Department
ALCOHOL AND GAMING DIVISION
Toney Anaya Building • 2550 Cerril los Road • Santa Fe, New Mexico 87505
(505) 476-4875 • Fax (505) 476-4595 • www.rld.state.nm.us/AGD

RECEIVED JUL 13 2015 ALCOHOL & GAMING DIVISION
75
173534

____Fee $75.00 **Fees are Non-Refundable**

CHANGE OF FLOOR PLAN /EXPANSION OF LIQUOR LICENSED PREMISE APPLICATION
15 NMAC 10.3.2 13.1

A Licensee may not change or expand the licensed premises without prior written approval of the Director. Applications to change or expand the licensed premises shall be submitted along with the required documentation and application fee. If the change or expansion of the licensed premises is twenty-five **(25%)** or more of the total existing square footage of the licensed premises, the Director may require the licensee to file an application for a transfer of location. **Proof of tenancy and photographs with a detailed floor are required for the expansion area. Please attach a copy of your existing approved floor plan along with an 8 ½ x 11detailed floor plan that includes the existing approved premises and any proposed change or expansion. Please label all areas and include all entrances, exits, walls or enclosures as well as dimensions for any expansion. The licensee cannot make any changes or expand the premises until approval has been granted for this request. A before and after site inspection may be scheduled.**

Liquor License Number 2746 Telephone Number 505-982-0883 Fax Number _____

Business Name (DBA) Santa Fe Cafe Owner Name Santa Fe Cafe, LLC

Mailing Address 101 S. Farrar Drive City Cape Girardeau State Missouri Zip 63701

License Location 228 E. Palace Ave City Santa Fe State New Mexico Zip 87501

Current square footage 195,000 Additional square footage you would like to add/change 1,400 patio

Total square footage (add both amounts above) 69,614 Reason for request Removing guest rooms and adding patio

Will the proposed expansion bring the licensed premises within 300 feet of a church or school? No

Has there been any change in the ownership or operation of the licensee? No

If so, explain _____

I Linda L. Aikin (print name) Licensee for Liquor License No. 2746 hereby attest that the requested change meets the definition of "licensed premises" in NMSA 1978 60-3A-3 (M), which states in part " 'licensed premises' means the contiguous areas or areas connected by indoor passageways of a structure and the outside dining, recreation and lounge areas of the structure that are under the direct control of the licensee..."

You must sign and date this form in the presence of a notary public

Submitted by (print name) Linda L. Aikin

Signature _____ Title Resident Agent Date 7-7-15

NOTARY PUBLIC USE ONLY

SUBSCRIBED AND SWORN TO before me this 7th Day of July 20 15 By Linda L. Aikin

Notary Public _____ My Commission Expires _____

OFFICIAL SEAL
Amelia J. Martinez
NOTARY PUBLIC
STATE OF NEW MEXICO
My Commission Expires: 7-1-18

LOCAL GOVERNING BODY APPROVAL – (Required on expansion requests only)

Print Name _____ Title _____ Date _____

Signature _____ Phone _____ Fax _____

Alcohol and Gaming Use Only: ✓ **Approved** _____ **Disapproved**

By Brenda Mares **Date** 7-13-15

ALCOHOL & GAMING DIVISION

RECEIVED
JUL 13 2015

FLOOR PLAN APPROVAL
Brenda Ulares
Date 7-13-15

CITY OF SANTA FE CODE SUMMARY
- ZONING DISTRICT: BCD
- SUB-DISTRICT: EAST MARCY/EAST PALACE
- HISTORIC DISTRICT: DOWNTOWN AND EASTSIDE
- ARCHEOLOGICAL DISTRICT: HISTORIC DOWNTOWN
- SETBACKS: FRONT = 10', SIDE = 5', REAR = 10'

LOT AREA = 213,892 S.F. (4.9 ACRES)

LOT COVERAGE
- EXISTING = 52, 114 S.F. (24.3%)
- MAXIMUM ALLOWED = NO LIMIT
- PROPOSED = 100,937 S.F. (51.8%)

OPEN SPACE
- REQUIRED = 10% (21,389 S.F.) OF LOT AREA TO BE AT STREET-FACING PROPERTY LINES
- PROVIDED = 16% (34,000 S.F.) AT STREET-FACING PROPERTY LINES
- TOTAL OPEN SPACE PROVIDED = 39.2% (83,886 S.F.)

KEYED NOTES
1. NEW MEDIAN AND CURB & GUTTER, SEE CIVIL DRAWINGS
2. RENOVATE BOLLARDS, SEE DETAILS
3. BOLLARDS WITH INTEGRAL LANDSCAPE LIGHTING, SEE LANDSCAPE AND LIGHTING PLANS
4. 6'-0" HIGH MASONRY WALL WITH STUCCO FINISH, SEE DETAILS
5. RAISED PLANTER, SEE LANDSCAPE PLANS FOR HEIGHT AND DETAILS
6. PERGOLA, SEE DETAILS
7. FIRE HYDRANT, SEE CIVIL & UTILITY DRAWINGS
8. 5' WIDE CONCRETE SIDEWALK
9. 8' WIDE CONCRETE SIDEWALK
10. OPEN STAIR DOWN TO BASEMENT LEVEL, SEE STAIR PLANS & DETAILS ON SHEET G-A801
11. RETRACTABLE GATE FOR LOADING & SOLID WASTE ZONE
12. RECYCLING CONTAINERS LOCATION
13. "ADA"-ACCESSIBLE CURB RAMP, SEE CIVIL DRAWINGS
14. 10-SPACE BICYCLE RACK
15. WATER METER BOX - SEE CIVIL DRAWINGS
16. DRYER VENT EXHAUST OUTLET, SEE MECHANICAL
17. DRYER VENT AIR INTAKE OPENING, SEE MECHANICAL
18. GAS METER, SEE CIVIL DRAWINGS, ALREADY PERMITTED

LEGEND
- AREA OF SITE UNDER A SEPARATE PERMIT, NOT PART OF THIS SUBMITTAL
- PROPERTY LINE
- BUILDING SETBACK LINE

TYPICAL PARKING SPACE DIMENSIONS
- 19'-0" / 9'-0" STANDARD SIZE
- 15'-6" / 8'-0" COMPACT SIZE
- 20'-0" / 9'-0" ADA-COMPLIANT SPACE

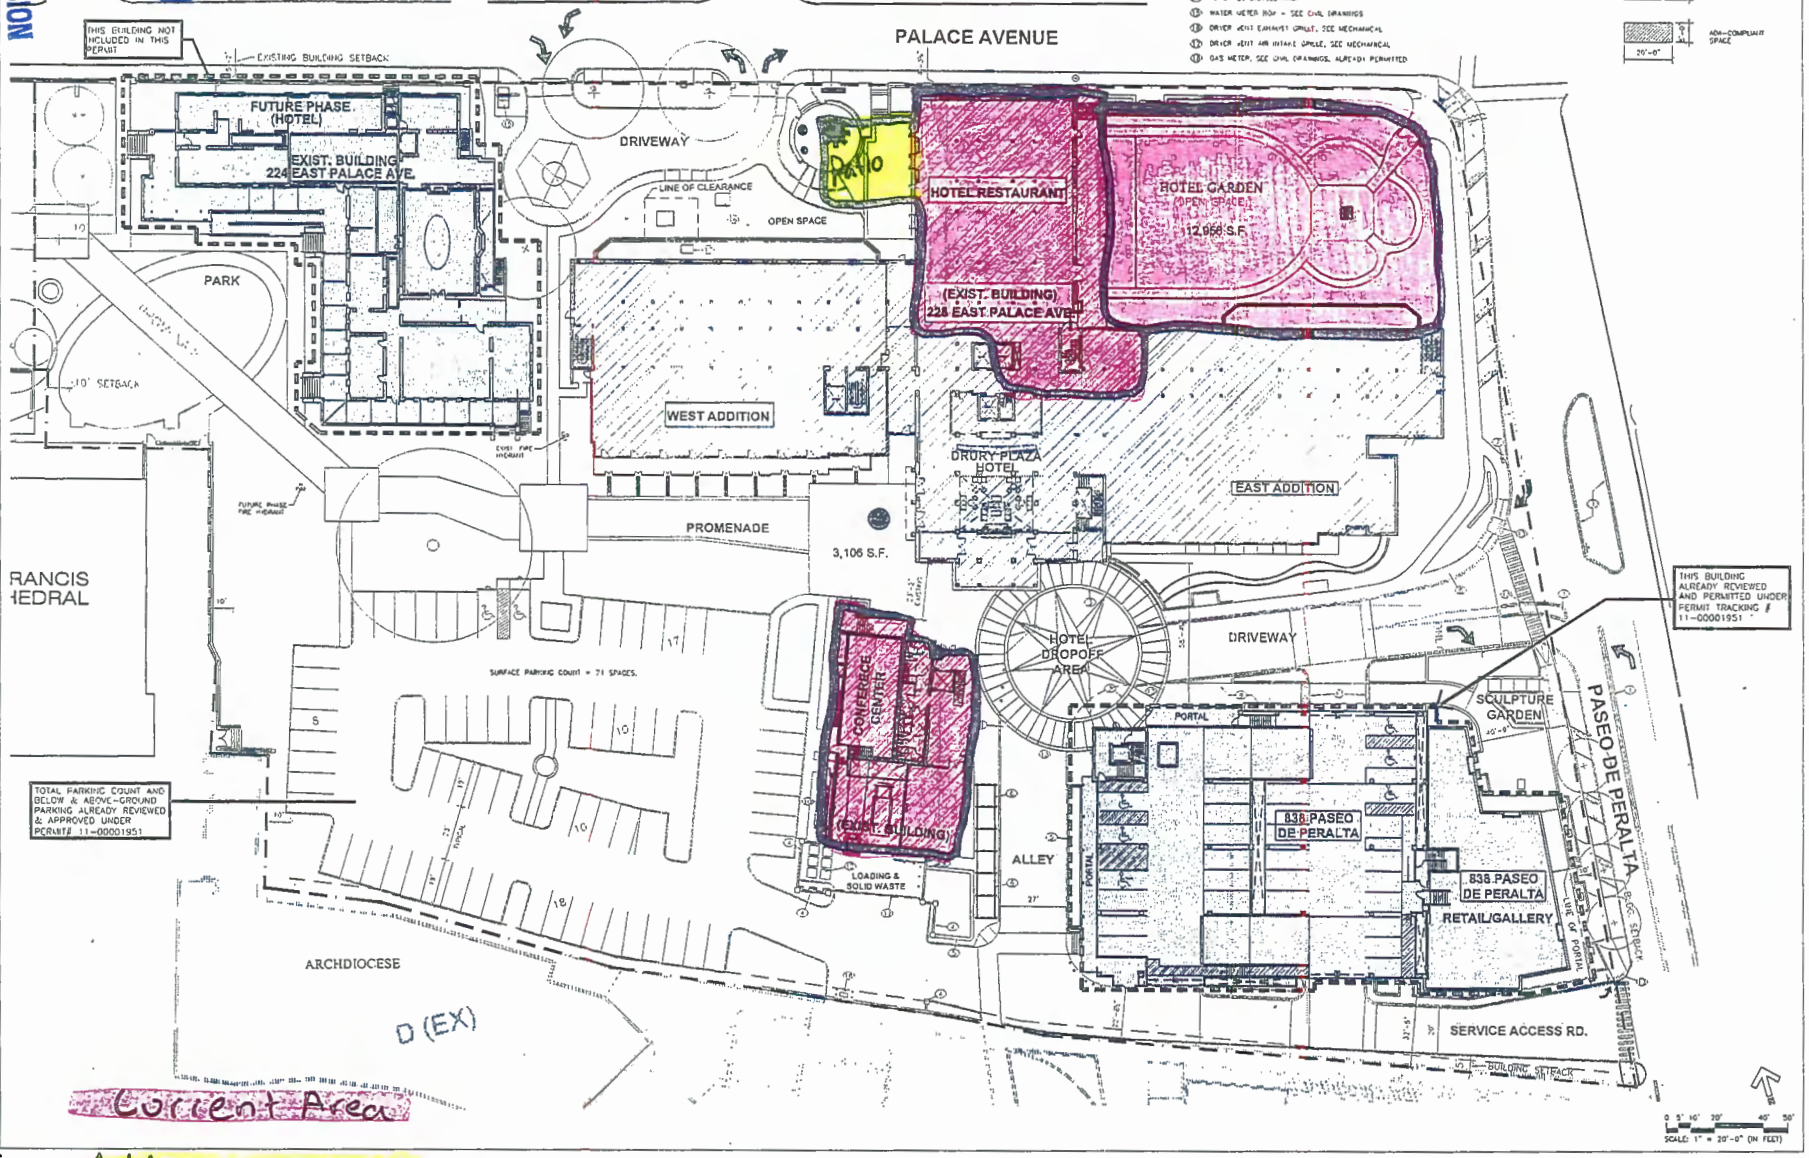

Current Area

Adding Area

DATE ISSUED: 06-24-2013 & CONSTRUCTION SET
REVISIONS:

BUILDING PERMIT / CONSTRUCTION DRAWINGS

DRURY SOUTHWEST INC.

Hogan Group

HOGAN GROUP INC. 505-984-1313 FAX 505-984-1001
ARCHITECTS - PLANNERS - INTERIOR DESIGNERS
201 CORTEZ ROAD, SANTA FE, NEW MEXICO 87505

DRURY PLAZA HOTEL

Restoration - Renovation - Additions
228 PALACE AVENUE
Santa Fe, New Mexico 87501

SITE PLAN

H.AS002.0

FLOOR PLAN APPROVAL
By [illegible]
Date 7/28/14

FLOOR PLAN APPROVAL
By Brenda Mares
Date 7-13-15

RECEIVED
JUL 13 2015
ALCOHOL & GAMING DIVISION

RECEIVED
JUL 16 2014
ALCOHOL & GAMING DIVISION

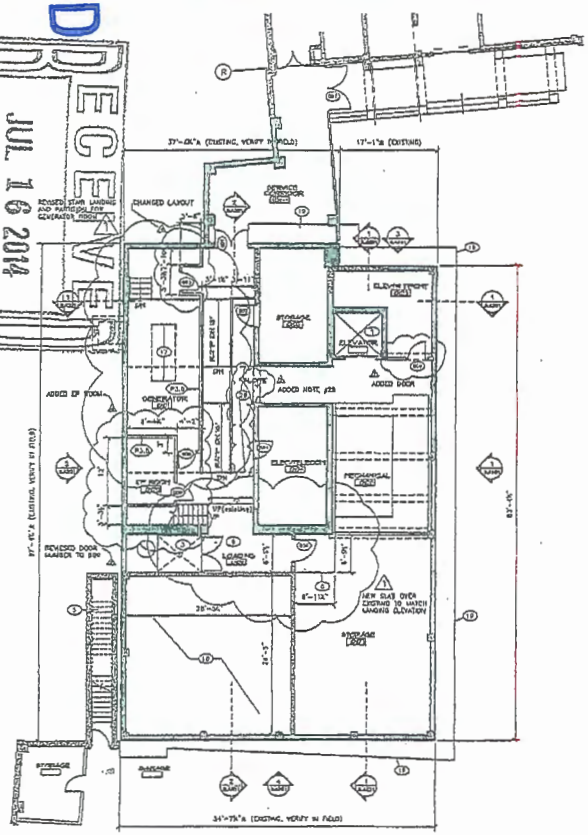

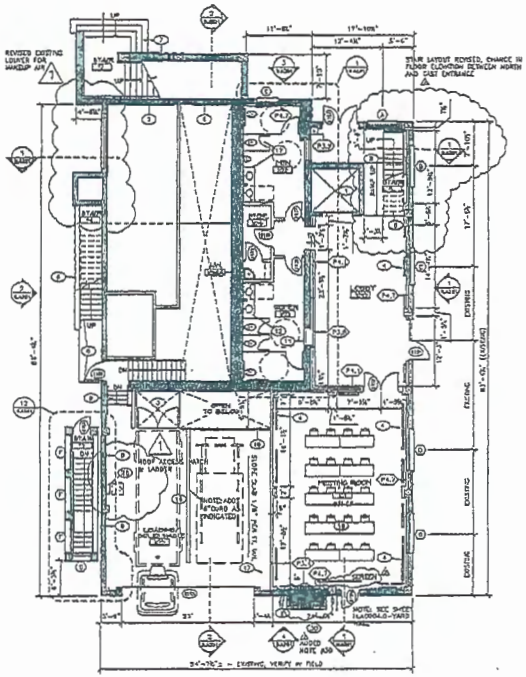

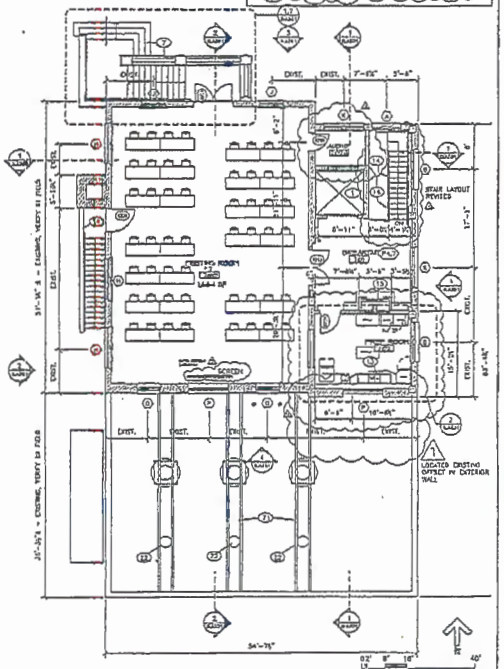

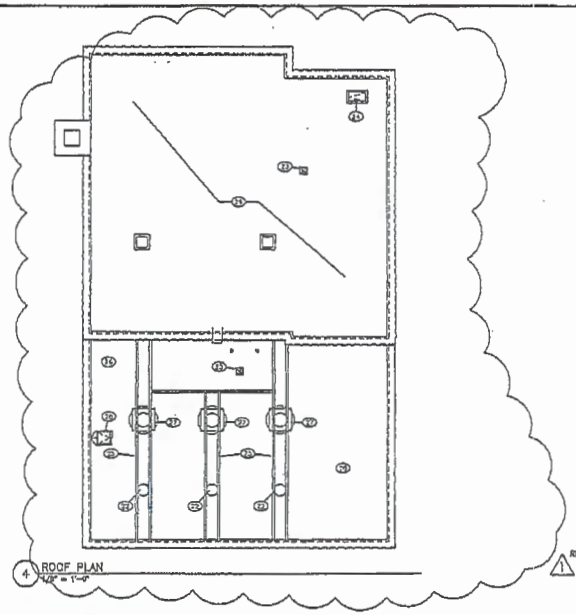

NEW WALL CONSTRUCTION
EXISTING MASONRY (BRICK) WALL TO REMAIN
EXISTING PARTITION TO REMAIN
EXISTING WALL/PARTITION TO BE REMOVED

KEYED NOTES

1. NEW ELEVATOR IN EXISTING ELEVATOR SHAFT.
2. NEW CONCRETE RAMP WITH GUARDRAILS & HANDRAILS, RECESSED INTO EXISTING FLOOR SLAB.
3. NEW FREIGHT LIFT, SEE MANUFACTURER DETAILS
4. IN-FLOOR GRILLE, SEE MECHANICAL PLANS
5. CONCRETE STAIR PREVIOUSLY CONSTRUCTED UNDER SEPARATE PERMIT.
6. NEW CONCRETE STAIR LANDING, SEE SECTION
7. NEW EXTERIOR STAIR.
8. NEW INTERIOR STAIR, SEE SHEET B.A505
9. INFILL EXISTING EXTERIOR WALL OPENING.
10. GUARDRAIL WITH GATED OPENING AT FREIGHT LIFT.
11. NOT USED
12. NEW PLUMBING FIXTURES, TOILET PARTITIONS, LAVATORY COUNTER AND TOILET ACCESSORIES.
13. TWO-COMPARTMENT SINK.
14. NEW GUARD RAIL AT STAIR
15. GAS FIREPLACE, FB
16. REMOVE FLOOR, LEAVE OPEN TO BELOW
17. MECHANICAL EQUIPMENT, SEE MECHANICAL PLANS
18. COMPACTED FILL, SEE STRUCTURAL
19. TOP OF EXISTING CONCRETE FOOTING
20. SOLID WASTE COMPACTOR, SEE SOLID WASTE PLAN
21. NEW STRUCTURE FOR SKIDSTEAK SUPPORTS, SEE STRUCTURAL
22. EXISTING SKIDSTEELS TO REMAIN, SEE STRUCTURAL FOR REMOVING TO STRUCTURAL SUPPORT
23. EXISTING ROOF DRAIN, APPROXIMATE LOCATION, VERIFY IN FIELD
24. EXISTING ROOF ACCESS HATCH
25. NEW STRUCTURAL FRAMING MEMBERS FOR SKIDSTEAK SUPPORTS, SEE STRUCTURAL
26. EXISTING ROOFING TO BE REPAIRED AS NEEDED.
27. MECHANICAL ROOF TOP EQUIPMENT, SEE MECHANICAL PLANS
28. METAL LADDER FOR ACCESS TO ROOF
29. NEW MECHANICAL FLOOR, SEE MECHANICAL PLANS
30. NEW EXHAUST VENT FROM GARAGE, SEE MECHANICAL PLANS

ISSUE/REVISIONS
REVISIONS: 1 07/20/2012; 2 4/12/2013; 3 7/16/2013; 4 08/28/13 - EV, PREP, AND AUDIO ROOMS; 5 04/13/14 - REVISED DOOR NUMBER TO 109
BUILDING PERMIT / CONSTRUCTION DRAWINGS

DRURY SOUTHWEST INC.
DEVELOPER: HogansGroup
HOGANSGROUP INC. 505.988.1885 FAX.505.988.5241
ARCHITECT: DRURY SOUTHWEST INC. ARCHITECTS
373 OLD PECOS TRAIL, SANTA FE, NEW MEXICO 87505

DRURY PLAZA HOTEL
Restoration - Renovation - Additions
228 PALACE AVENUE
Santa Fe, New Mexico 87501

Conference/Service Bldg. Floor Plans

B.A101

Confrence Center detailed
7500 sq. ft totally unrestricted

Marshall

13

Photos attached

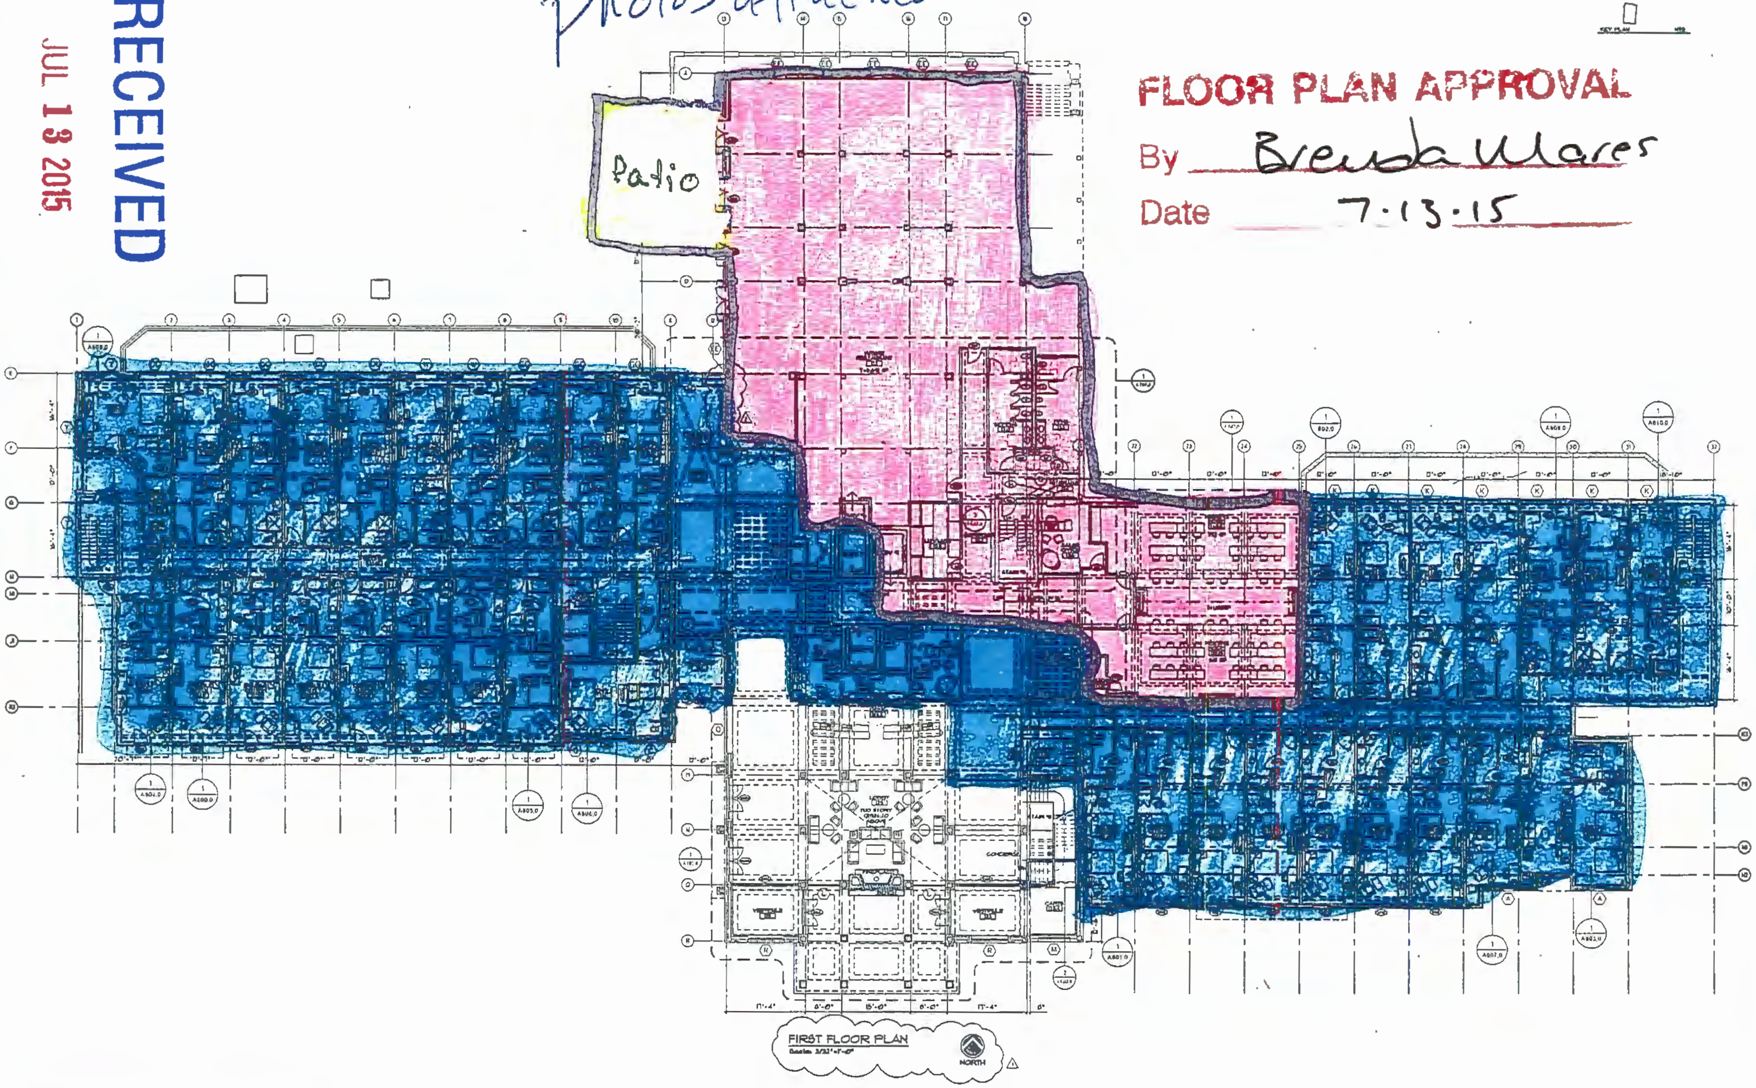

FLOOR PLAN APPROVAL

By Brenda Mares

Date 7·13·15

RECEIVED
JUL 13 2015
ALCOHOL & GAMING DIVISION

Current Area

Adding Area

Remaining Area

DATE ISSUED: 07/13/2012 PERMIT CONSTRUCTION SET DATE: 8/24/2012

REVISIONS

△ 9/28/2012

△ 12/14/2012

△ TUB AND SHOWER CHANGES SEE RU BLOWUPS FOR DETAILS 1/31/13

BUILDING PERMIT / CONSTRUCTION DRAWINGS

DRURY SOUTHWEST INC.

HoganGroup

HOGAN GROUP INC. 505-988-1913 FAX 505-988-5034

ARCHITECTS • PLANNERS • INTERIORS • LANDSCAPES

952 OLD PECOS TRAIL SANTA FE, NEW MEXICO 87505

DRURY PLAZA HOTEL

Restoration - Renovation - Additions

228 PALACE AVENUE

Santa Fe, New Mexico 87501

FIRST FLOOR PLAN

H.A101.0

RECEIVED
JUL 13 2015
ALCOHOL & GAMING DIVISION

FLOOR PLAN APPROVAL
By Brenda Mares
Date 7-13-15

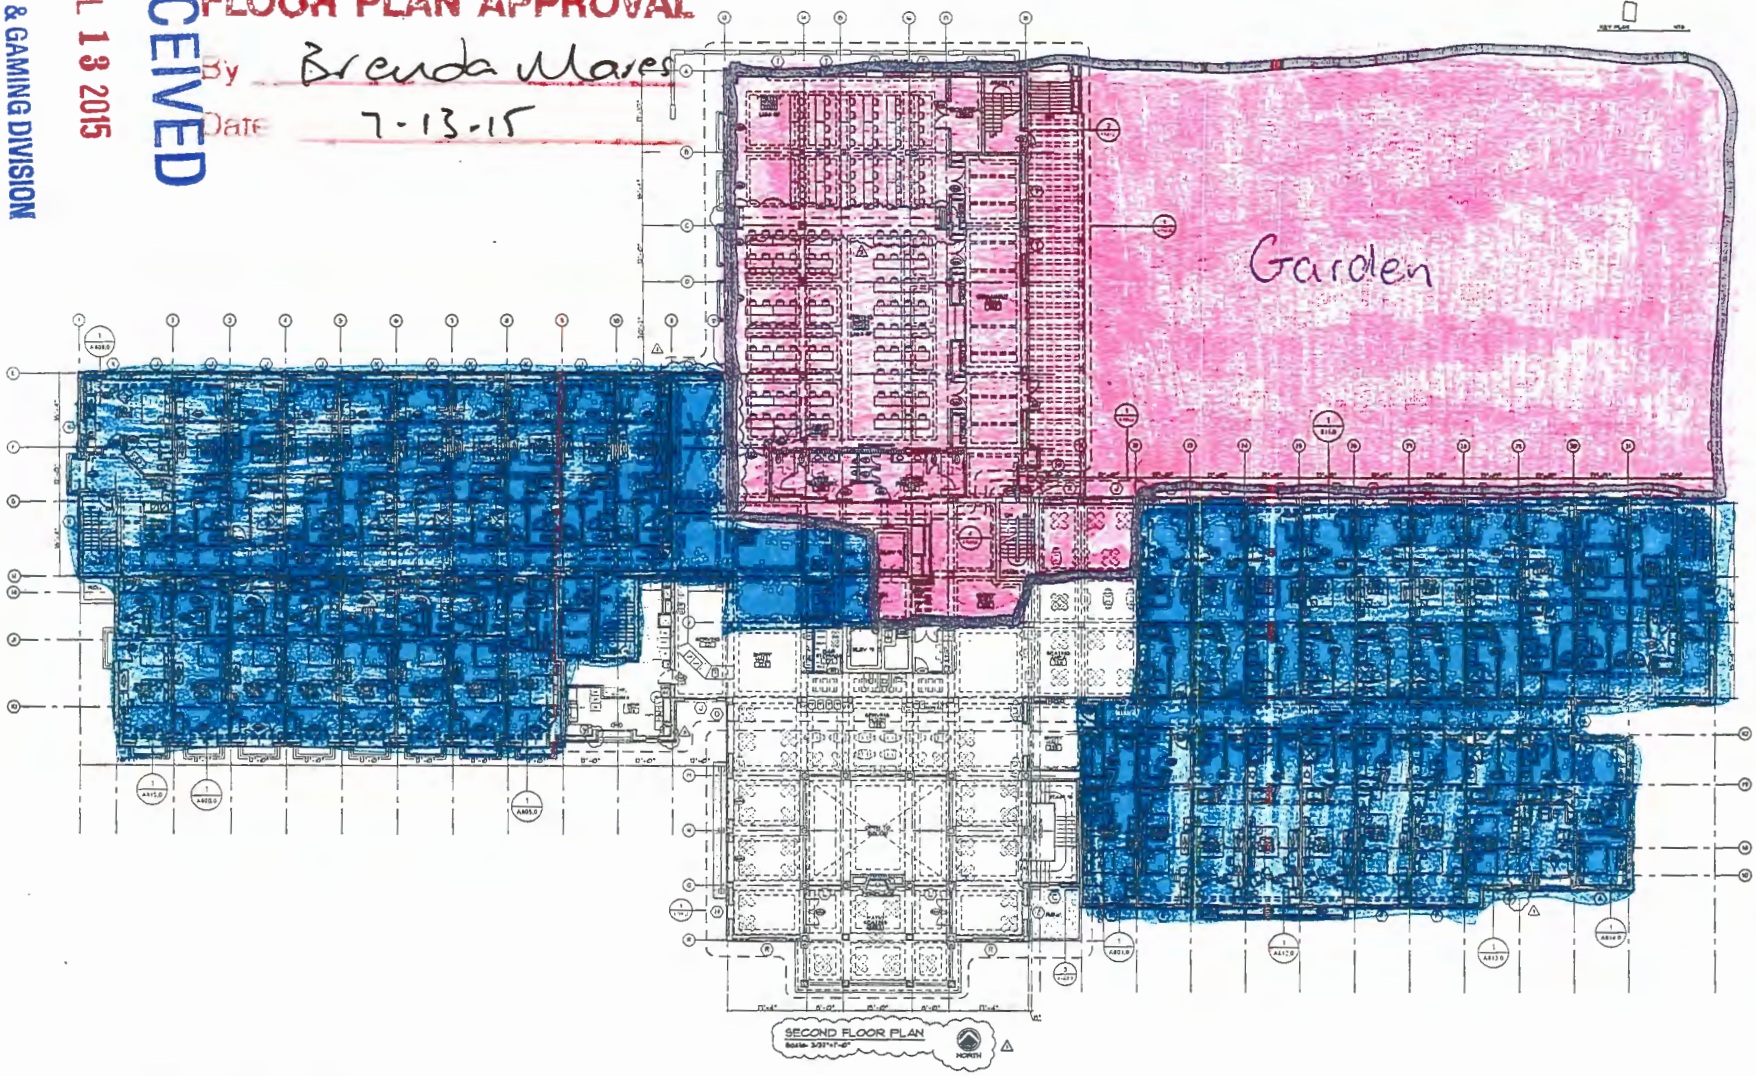

Current Area

Removing Area

DRURY SOUTHWEST INC.

HoganGroup

DRURY PLAZA HOTEL
Restoration - Renovation - Additions
228 PALACE AVENUE
Santa Fe, New Mexico 87501

SECOND FLOOR PLAN

H.A102.0

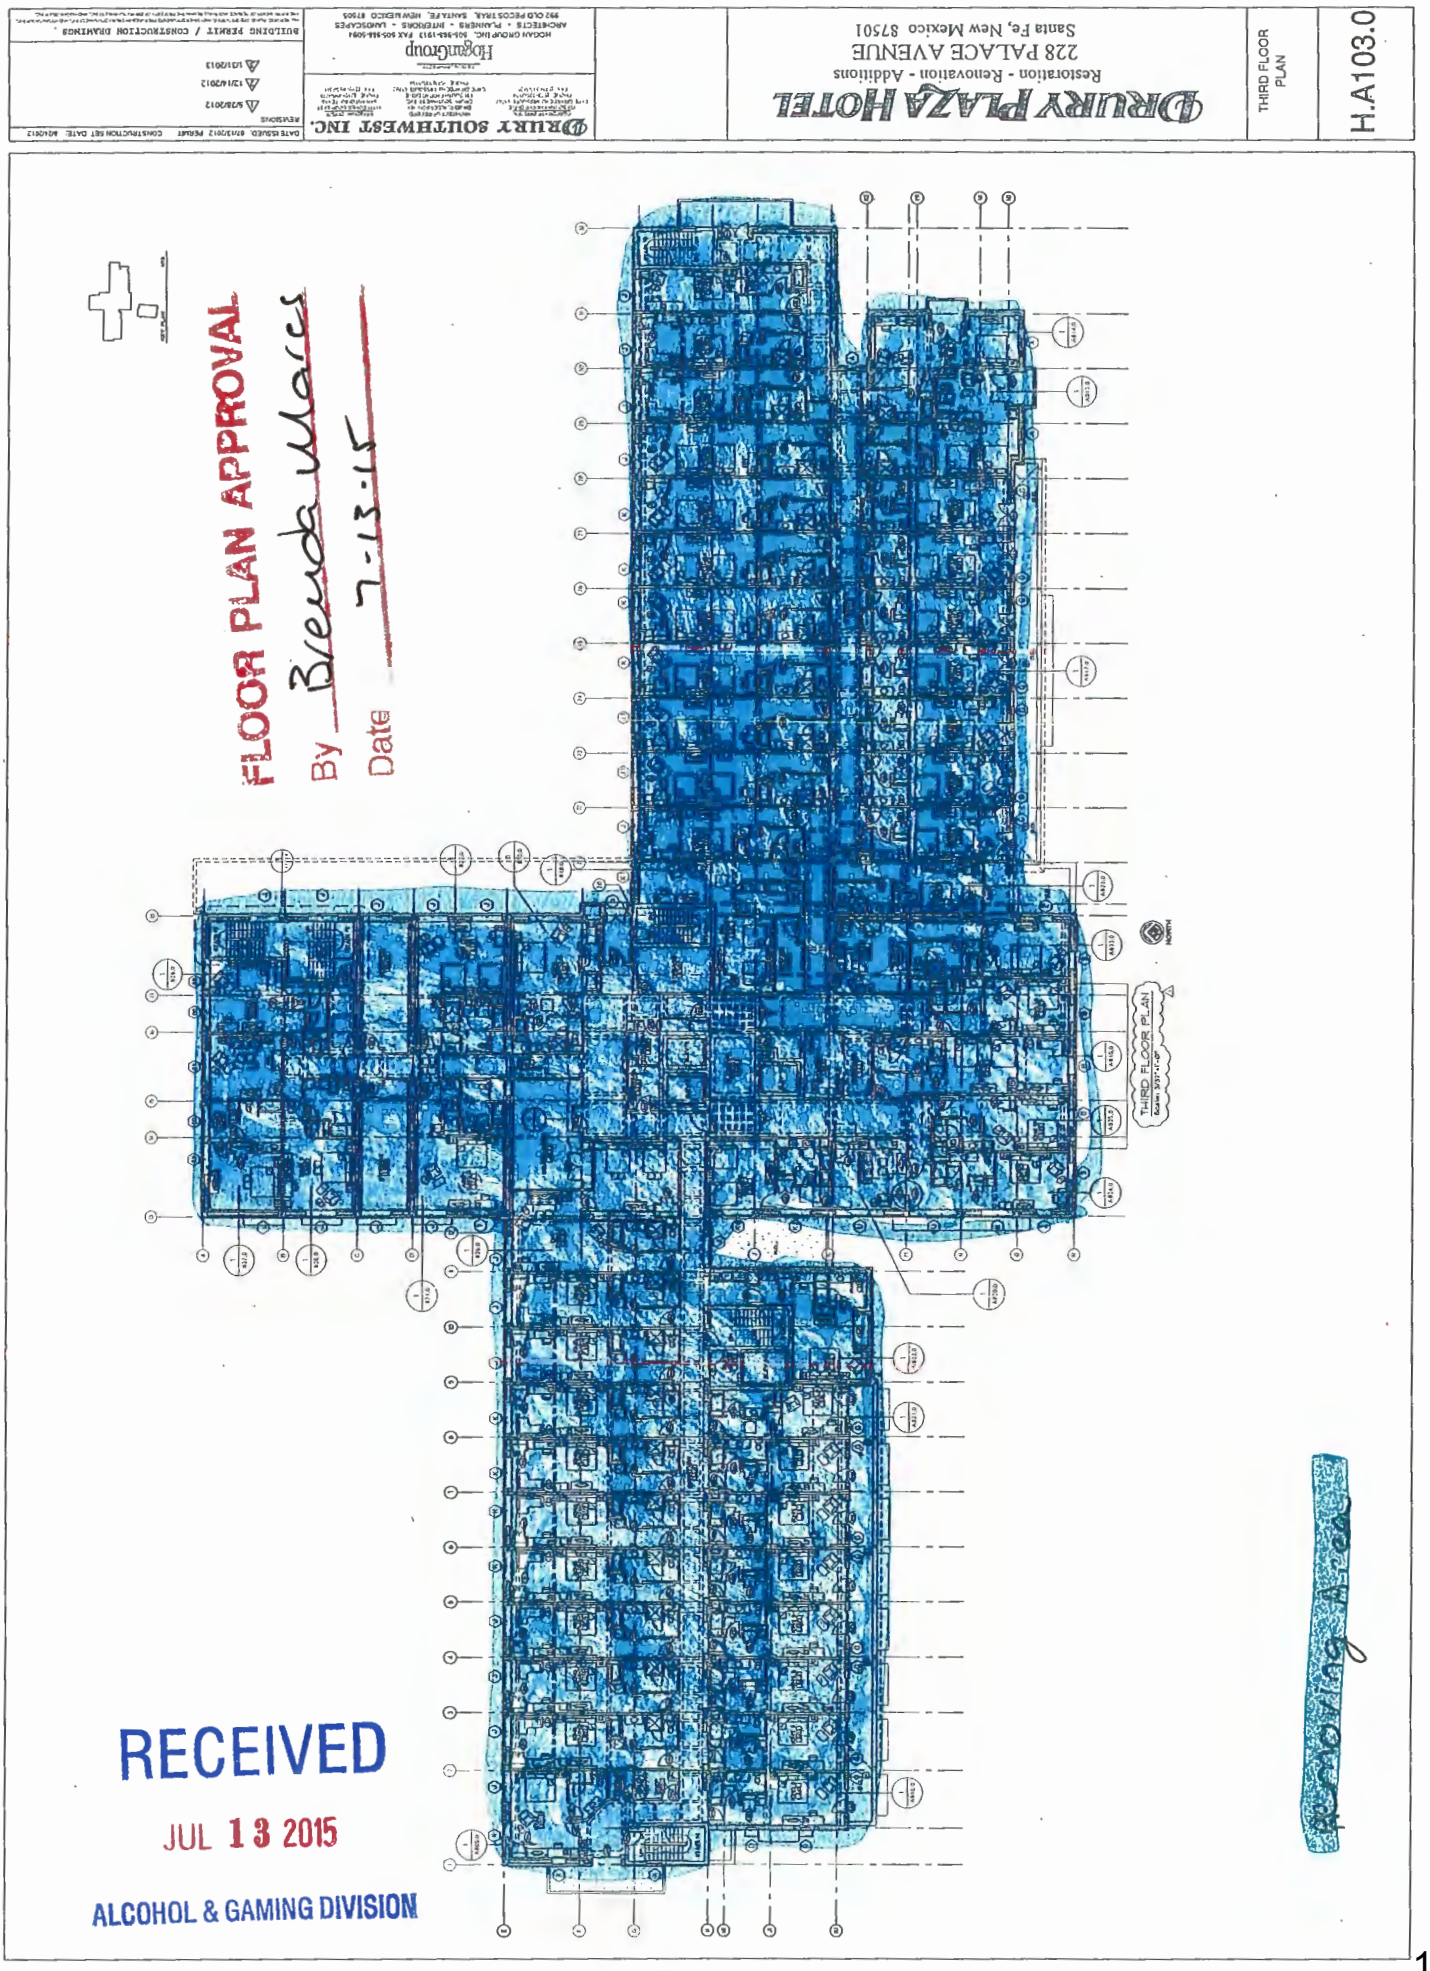
DRURY PLAZA HOTEL
Restoration - Renovation - Additions
228 PALACE AVENUE
Santa Fe, New Mexico 87501
THIRD FLOOR PLAN
H.A103.0
DRURY SOUTHWEST INC.
HoganGroup
BUILDING PERMIT / CONSTRUCTION DRAWINGS
FLOOR PLAN APPROVAL
By Brenda Mares
Date 7-13-15
THIRD FLOOR PLAN
RECEIVED
JUL 13 2015
ALCOHOL & GAMING DIVISION

RECEIVED
JUL 13 2015
ALCOHOL & GAMING DIVISION

FLOOR PLAN APPROVAL
By Brenda Mares
Date 7-13-15

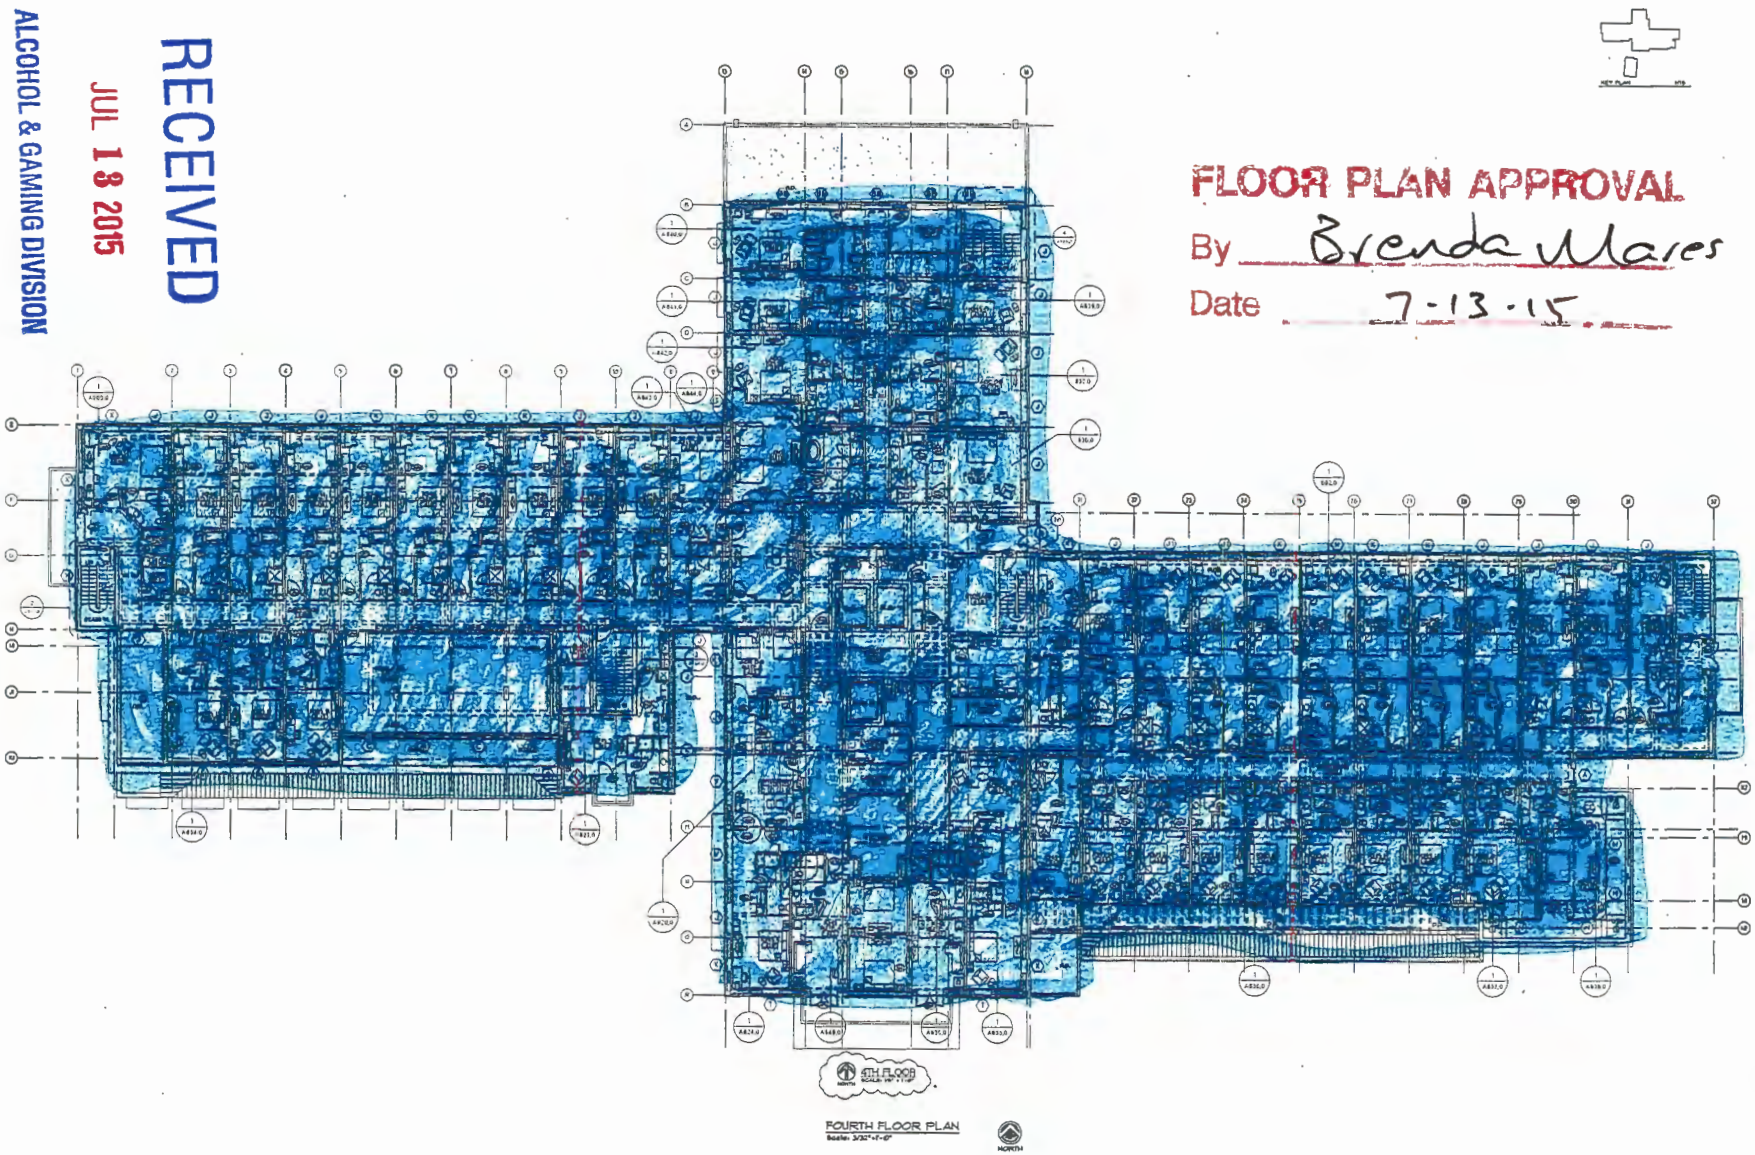

FOURTH FLOOR PLAN
Scale: 3/32"=1'-0"

Removing Area

DRURY SOUTHWEST INC.

HoganGroup
HOGAN GROUP INC. 505-988-1913 FAX 505-988-5054
ARCHITECTS - PLANNERS - INTERIORS - LANDSCAPES
992 OLD PECOS TRAIL SANTA FE, NEW MEXICO 87505

DATE ISSUED: 8/13/2012 PERMIT CONSTRUCTION SET DATE: 8/24/2012
REVISIONS:
8/28/2012
13/14/2012
TUB AND SHOWER CHANGES SEE RU BLOWUPS FOR DETAILS 1/11/13

BUILDING PERMIT / CONSTRUCTION DRAWINGS

DRURY PLAZA HOTEL
Restoration - Renovation - Additions
228 PALACE AVENUE
Santa Fe, New Mexico 87501

FOURTH FLOOR PLAN

H.A104.0

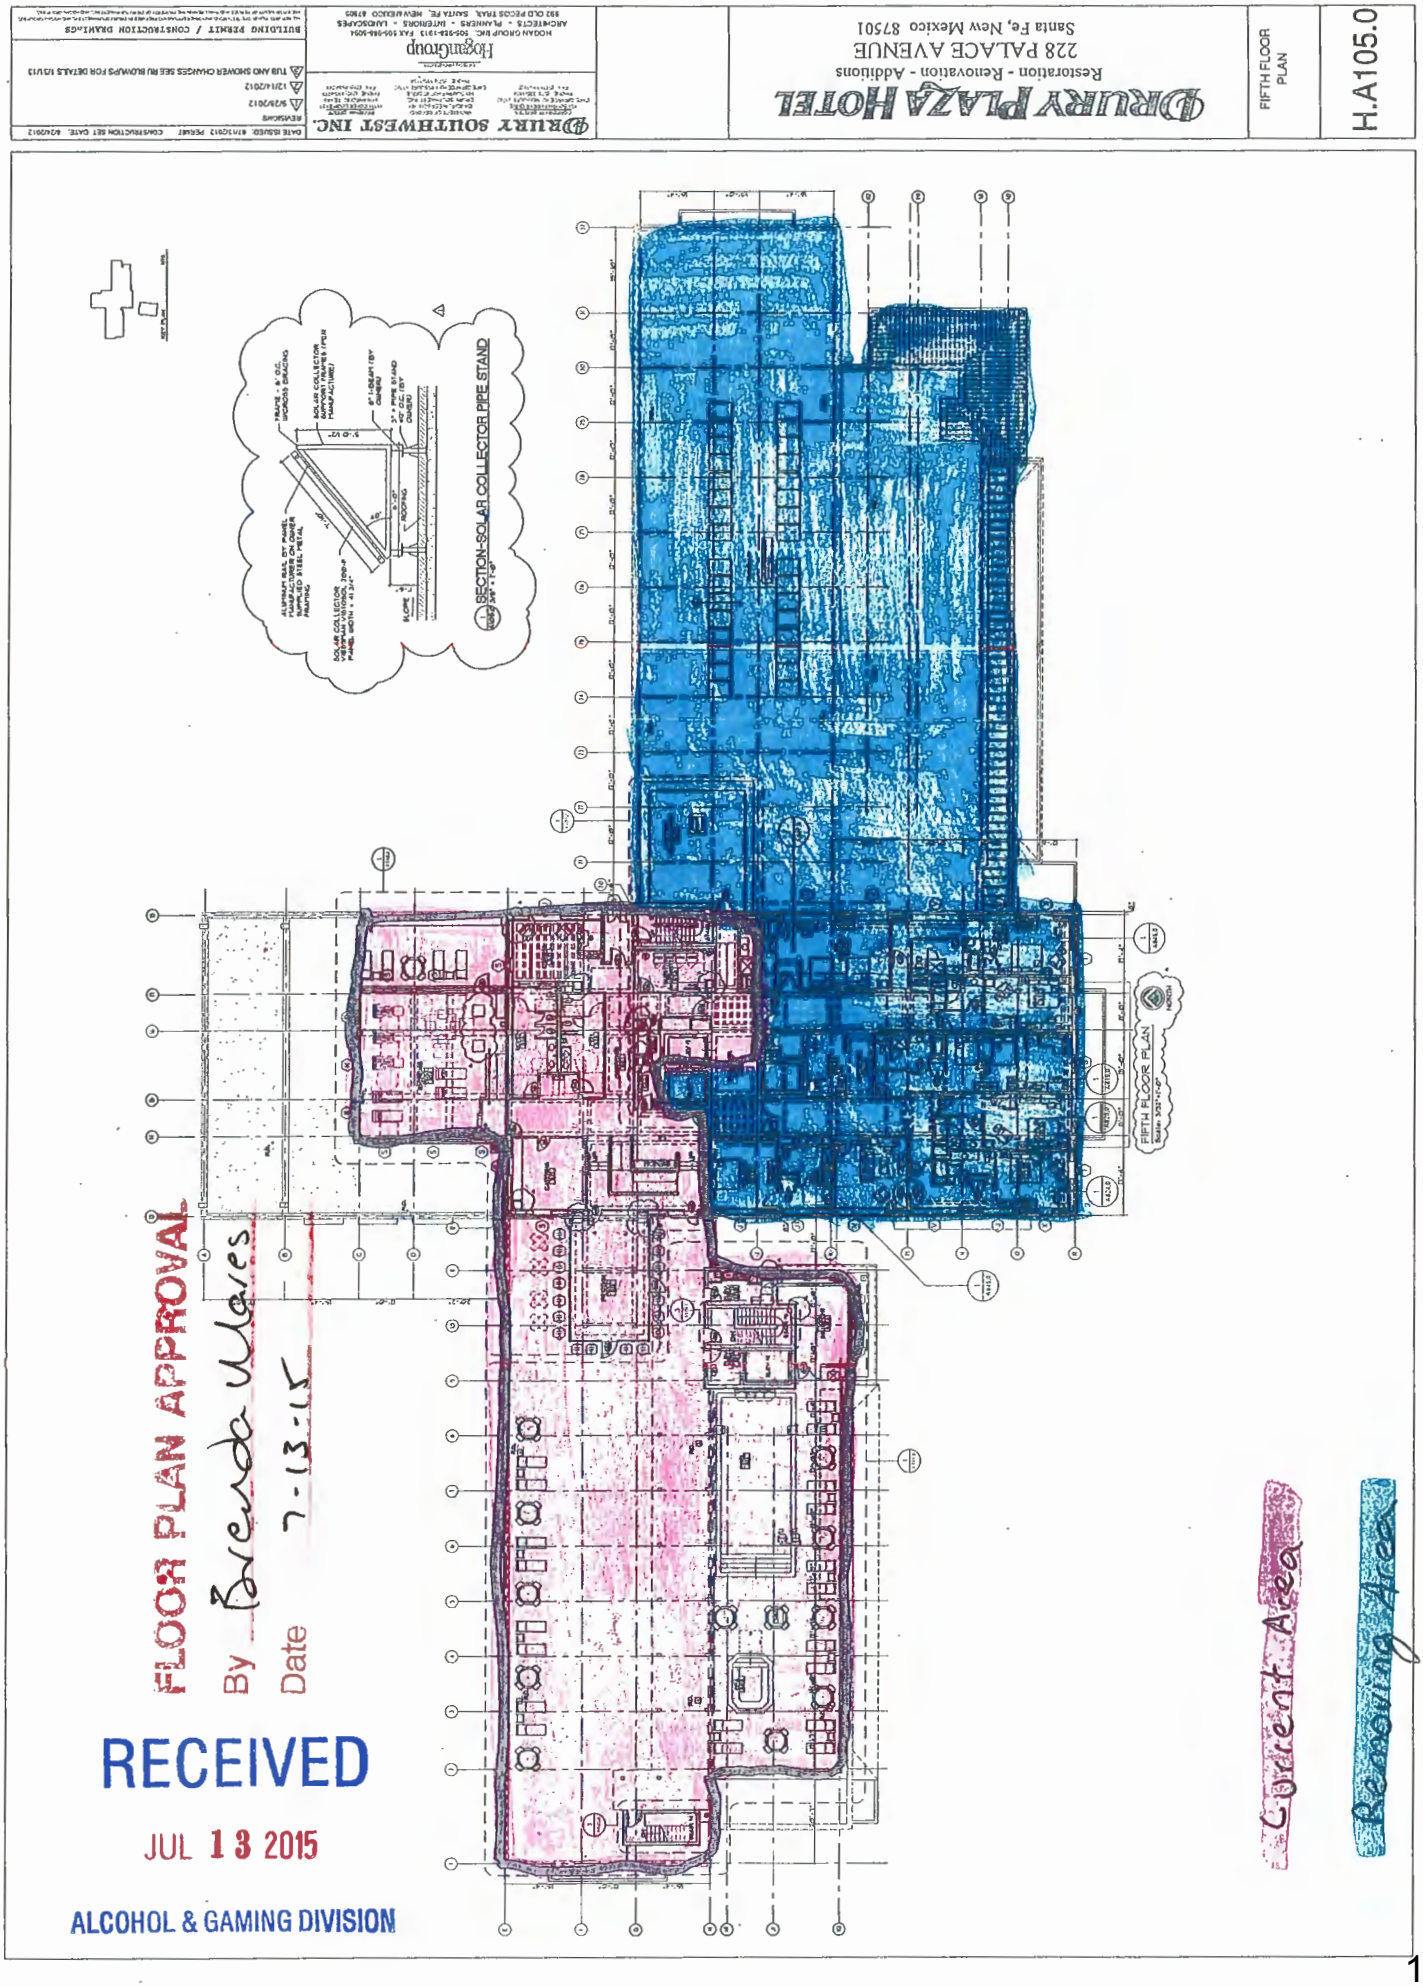
DRURY PLAZA HOTEL
Restoration - Renovation - Additions
228 PALACE AVENUE
Santa Fe, New Mexico 87501
FIFTH FLOOR PLAN
H.A105.0
DRURY SOUTHWEST INC.
Hogan Group
SECTION-SOLAR COLLECTOR PIPE STAND
FIFTH FLOOR PLAN
FLOOR PLAN APPROVAL
By Brenda Ulares
Date 7-13-15
RECEIVED
JUL 13 2015
ALCOHOL & GAMING DIVISION
Current Area
Removing Area

RECEIVED
JUL 16 2014
ALCOHOL & GAMING DIVISION

Normally locked to the public

Gate for Garden Area

Photos attached

License 2746

RECEIVED
JUL 13 2015
ALCOHOL & GAMING DIVISION

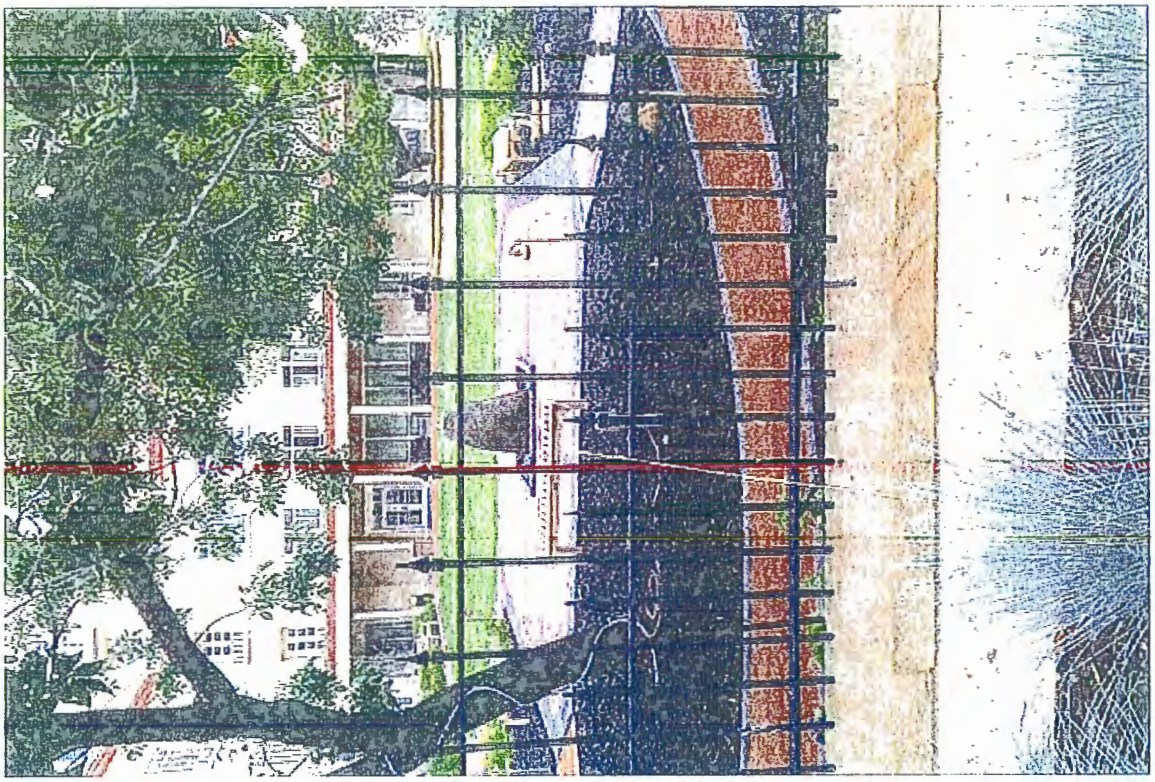

RECEIVED
JUL 13 2015
ALCOHOL & GAMING DIVISION

RECEIVED
JUL 13 2015
ALCOHOL & GAMING DIVISION

RECEIVED
JUL 13 2015
ALCOHOL & GAMING DIVISION